


**NOTE:**

The 30-pin variant of the BelaSigna R262 DSP is being phased out and not recommended for new designs! The 26-pin variant of the BelaSigna R262 DSP (BR262W26A103E1G) is recommended for new designs.

As thereof, this schematic contains annotations (red markups) to highlight functionality that is not supported (do not assembly) by the 26-pin variant BR262W26A103E1G.


Sällberg Technologies - www.sallberg.at - 28.02.2018

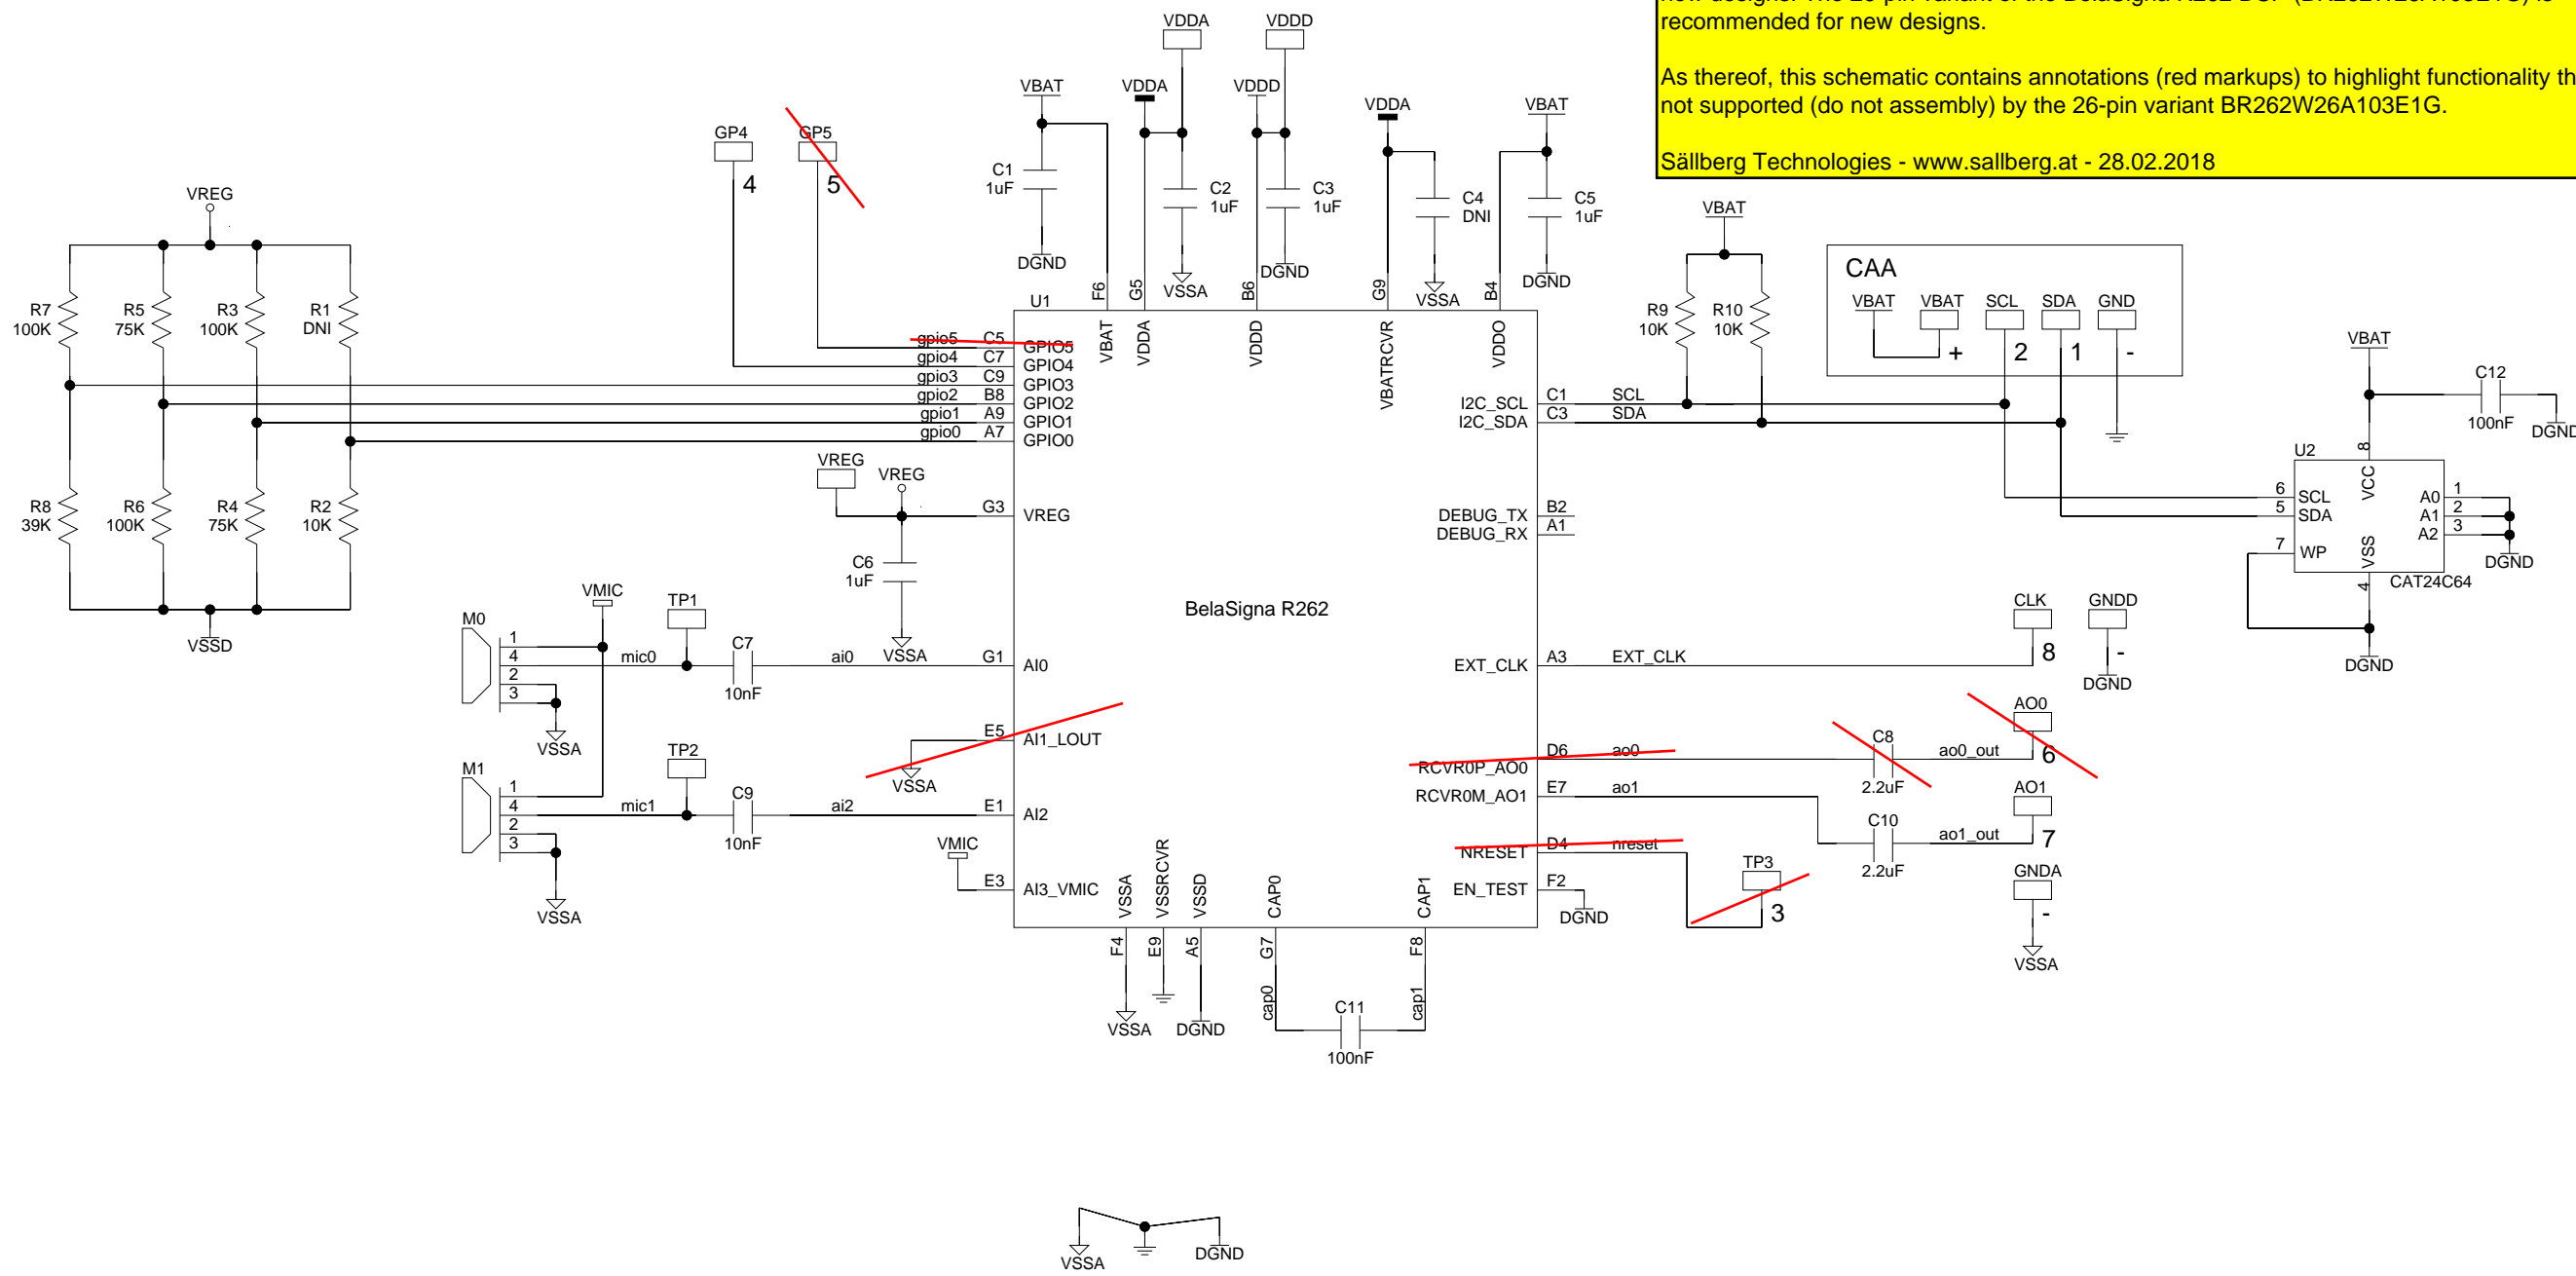

NOTE: Numbers on the test points indicate silkscreen labels on PCB

REVISION HISTORY

V1.0	Initial Design
V1.01	R8 changed from 75K to 39K

 611 Kumpf Drive, Unit 200 Waterloo, Ontario Canada, N2V 1K8		TITLE	
		PM2 Bravo R262	
SIZE	DWG NO	REV	
B	100682	1.01	
DRAWN BY		DATE	SHEET
M. Witter		3-Oct-2012	1 of 1